
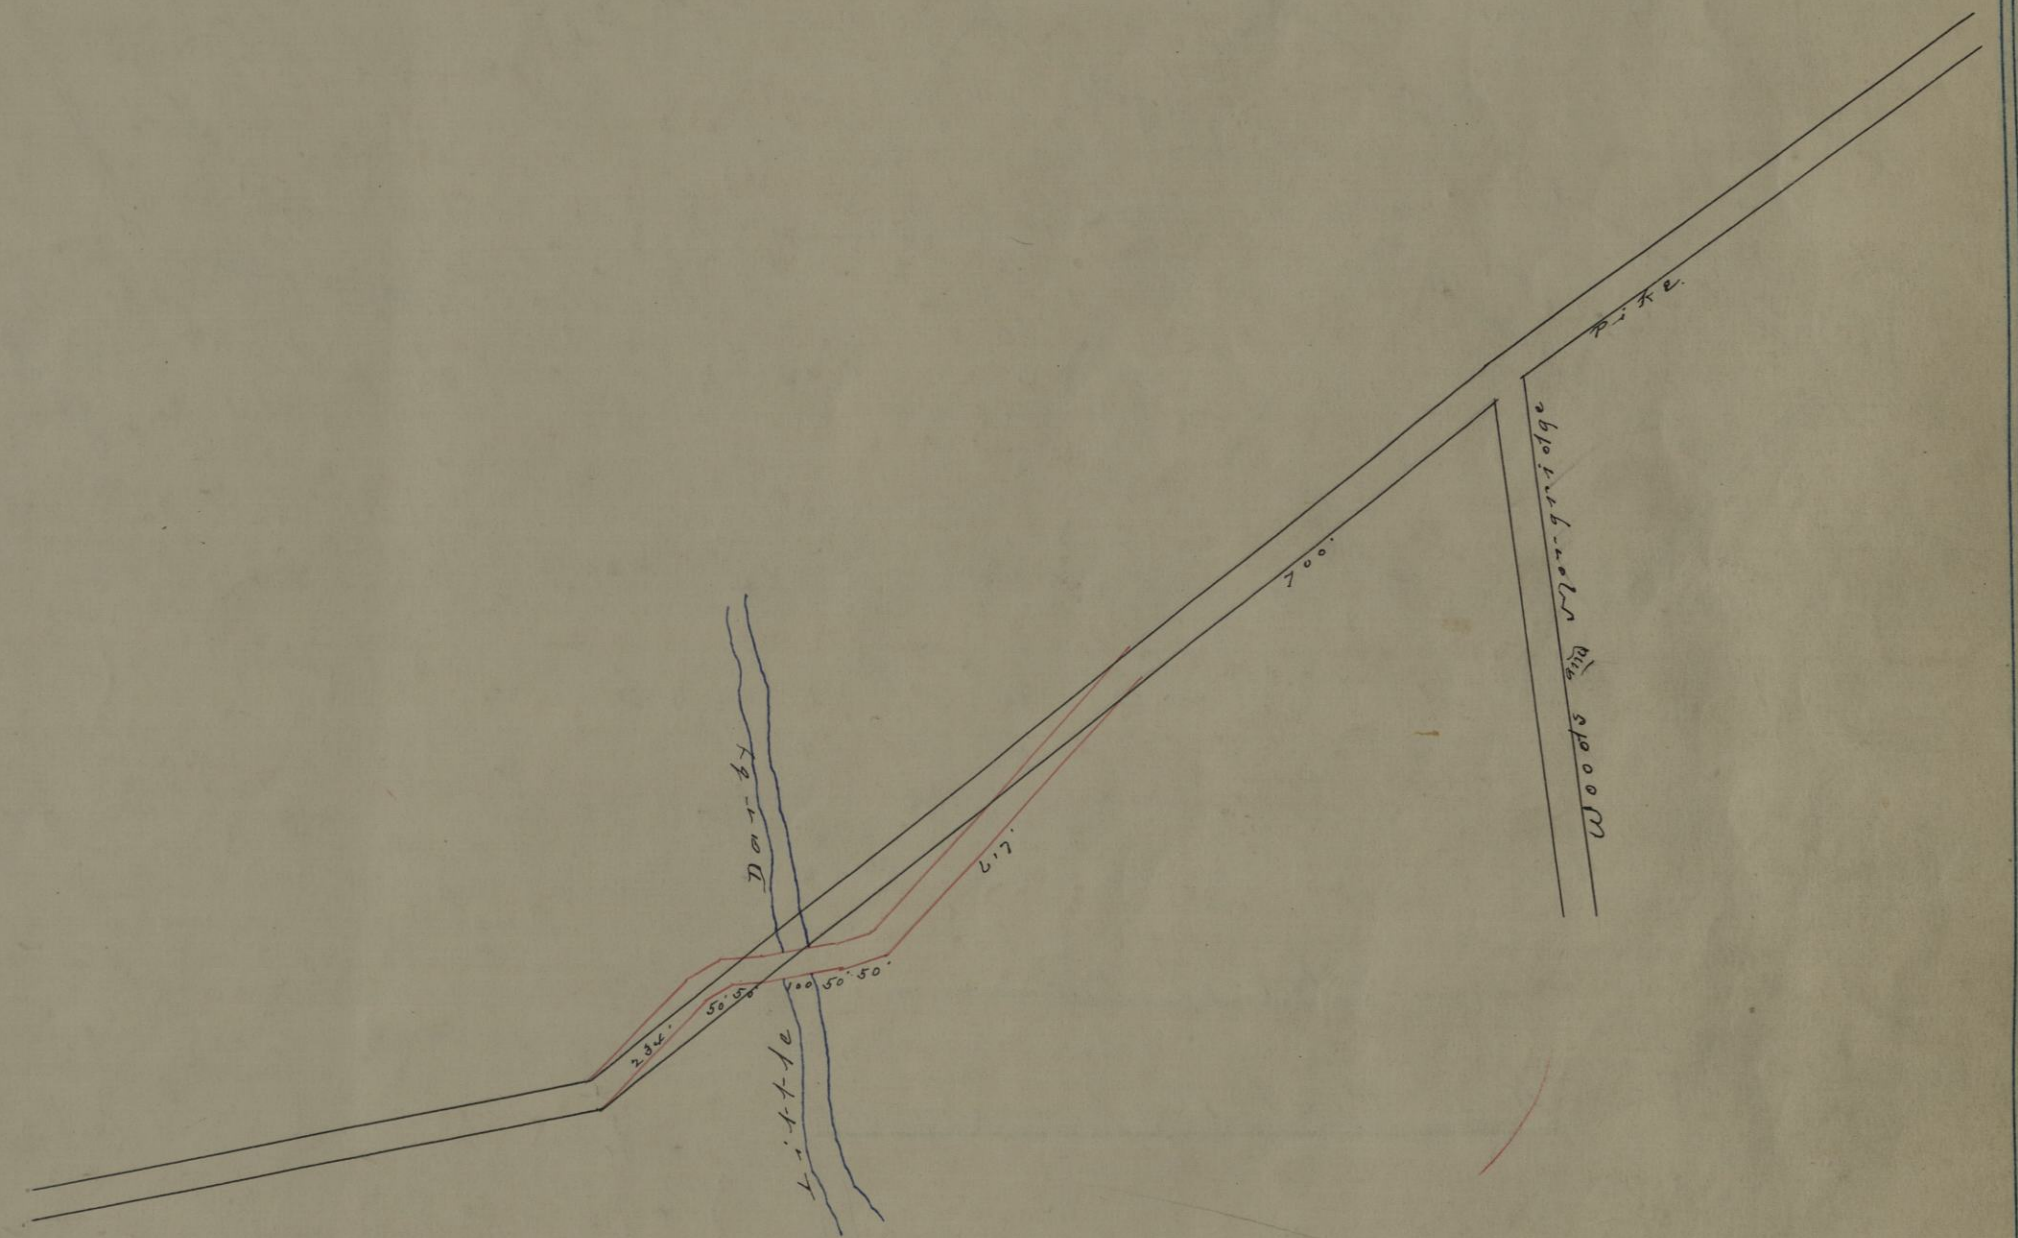


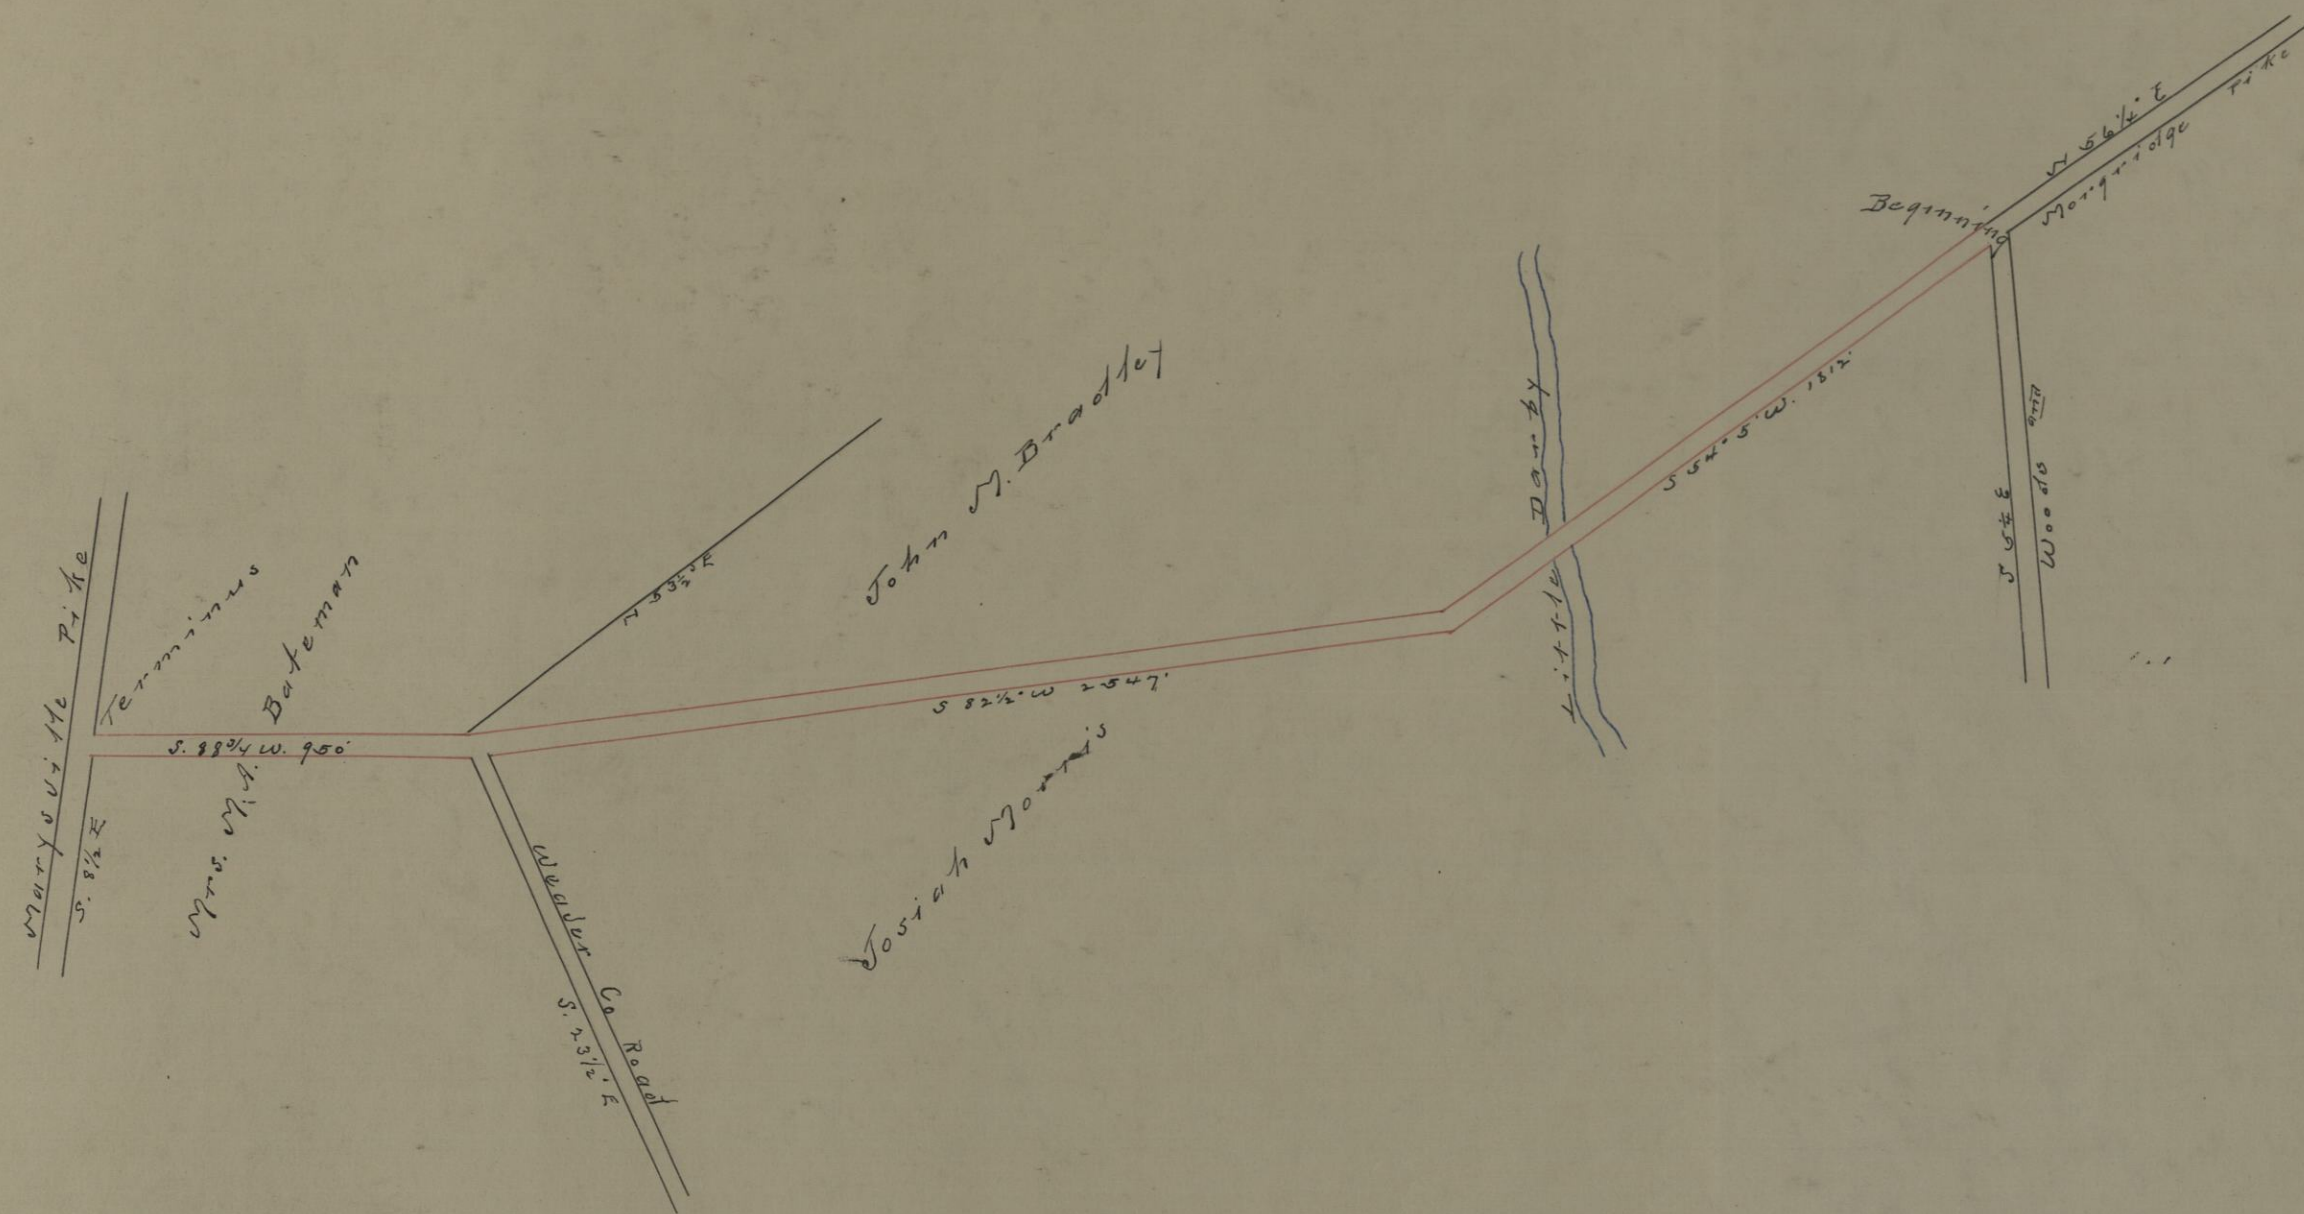

Plat of the
Bradley and Morris Road Imp.
Monroe Tp. Madison Co. O.
Scale 500' = 1 inch.

Plat of the
Alteration of the
Bradley and Morris Road.
Red lines showing the Alteration.