
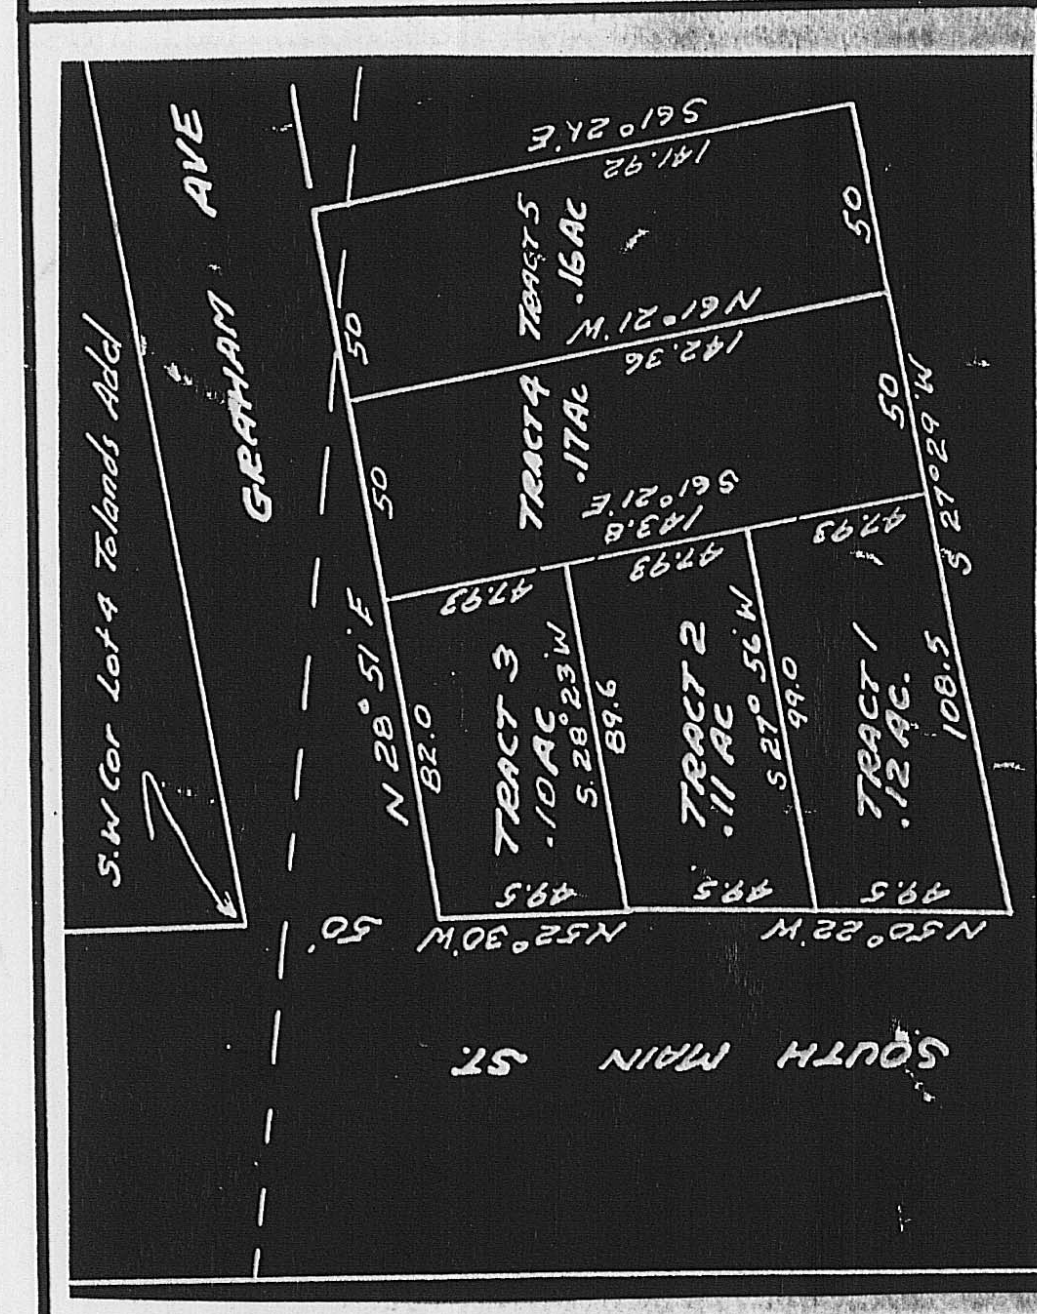
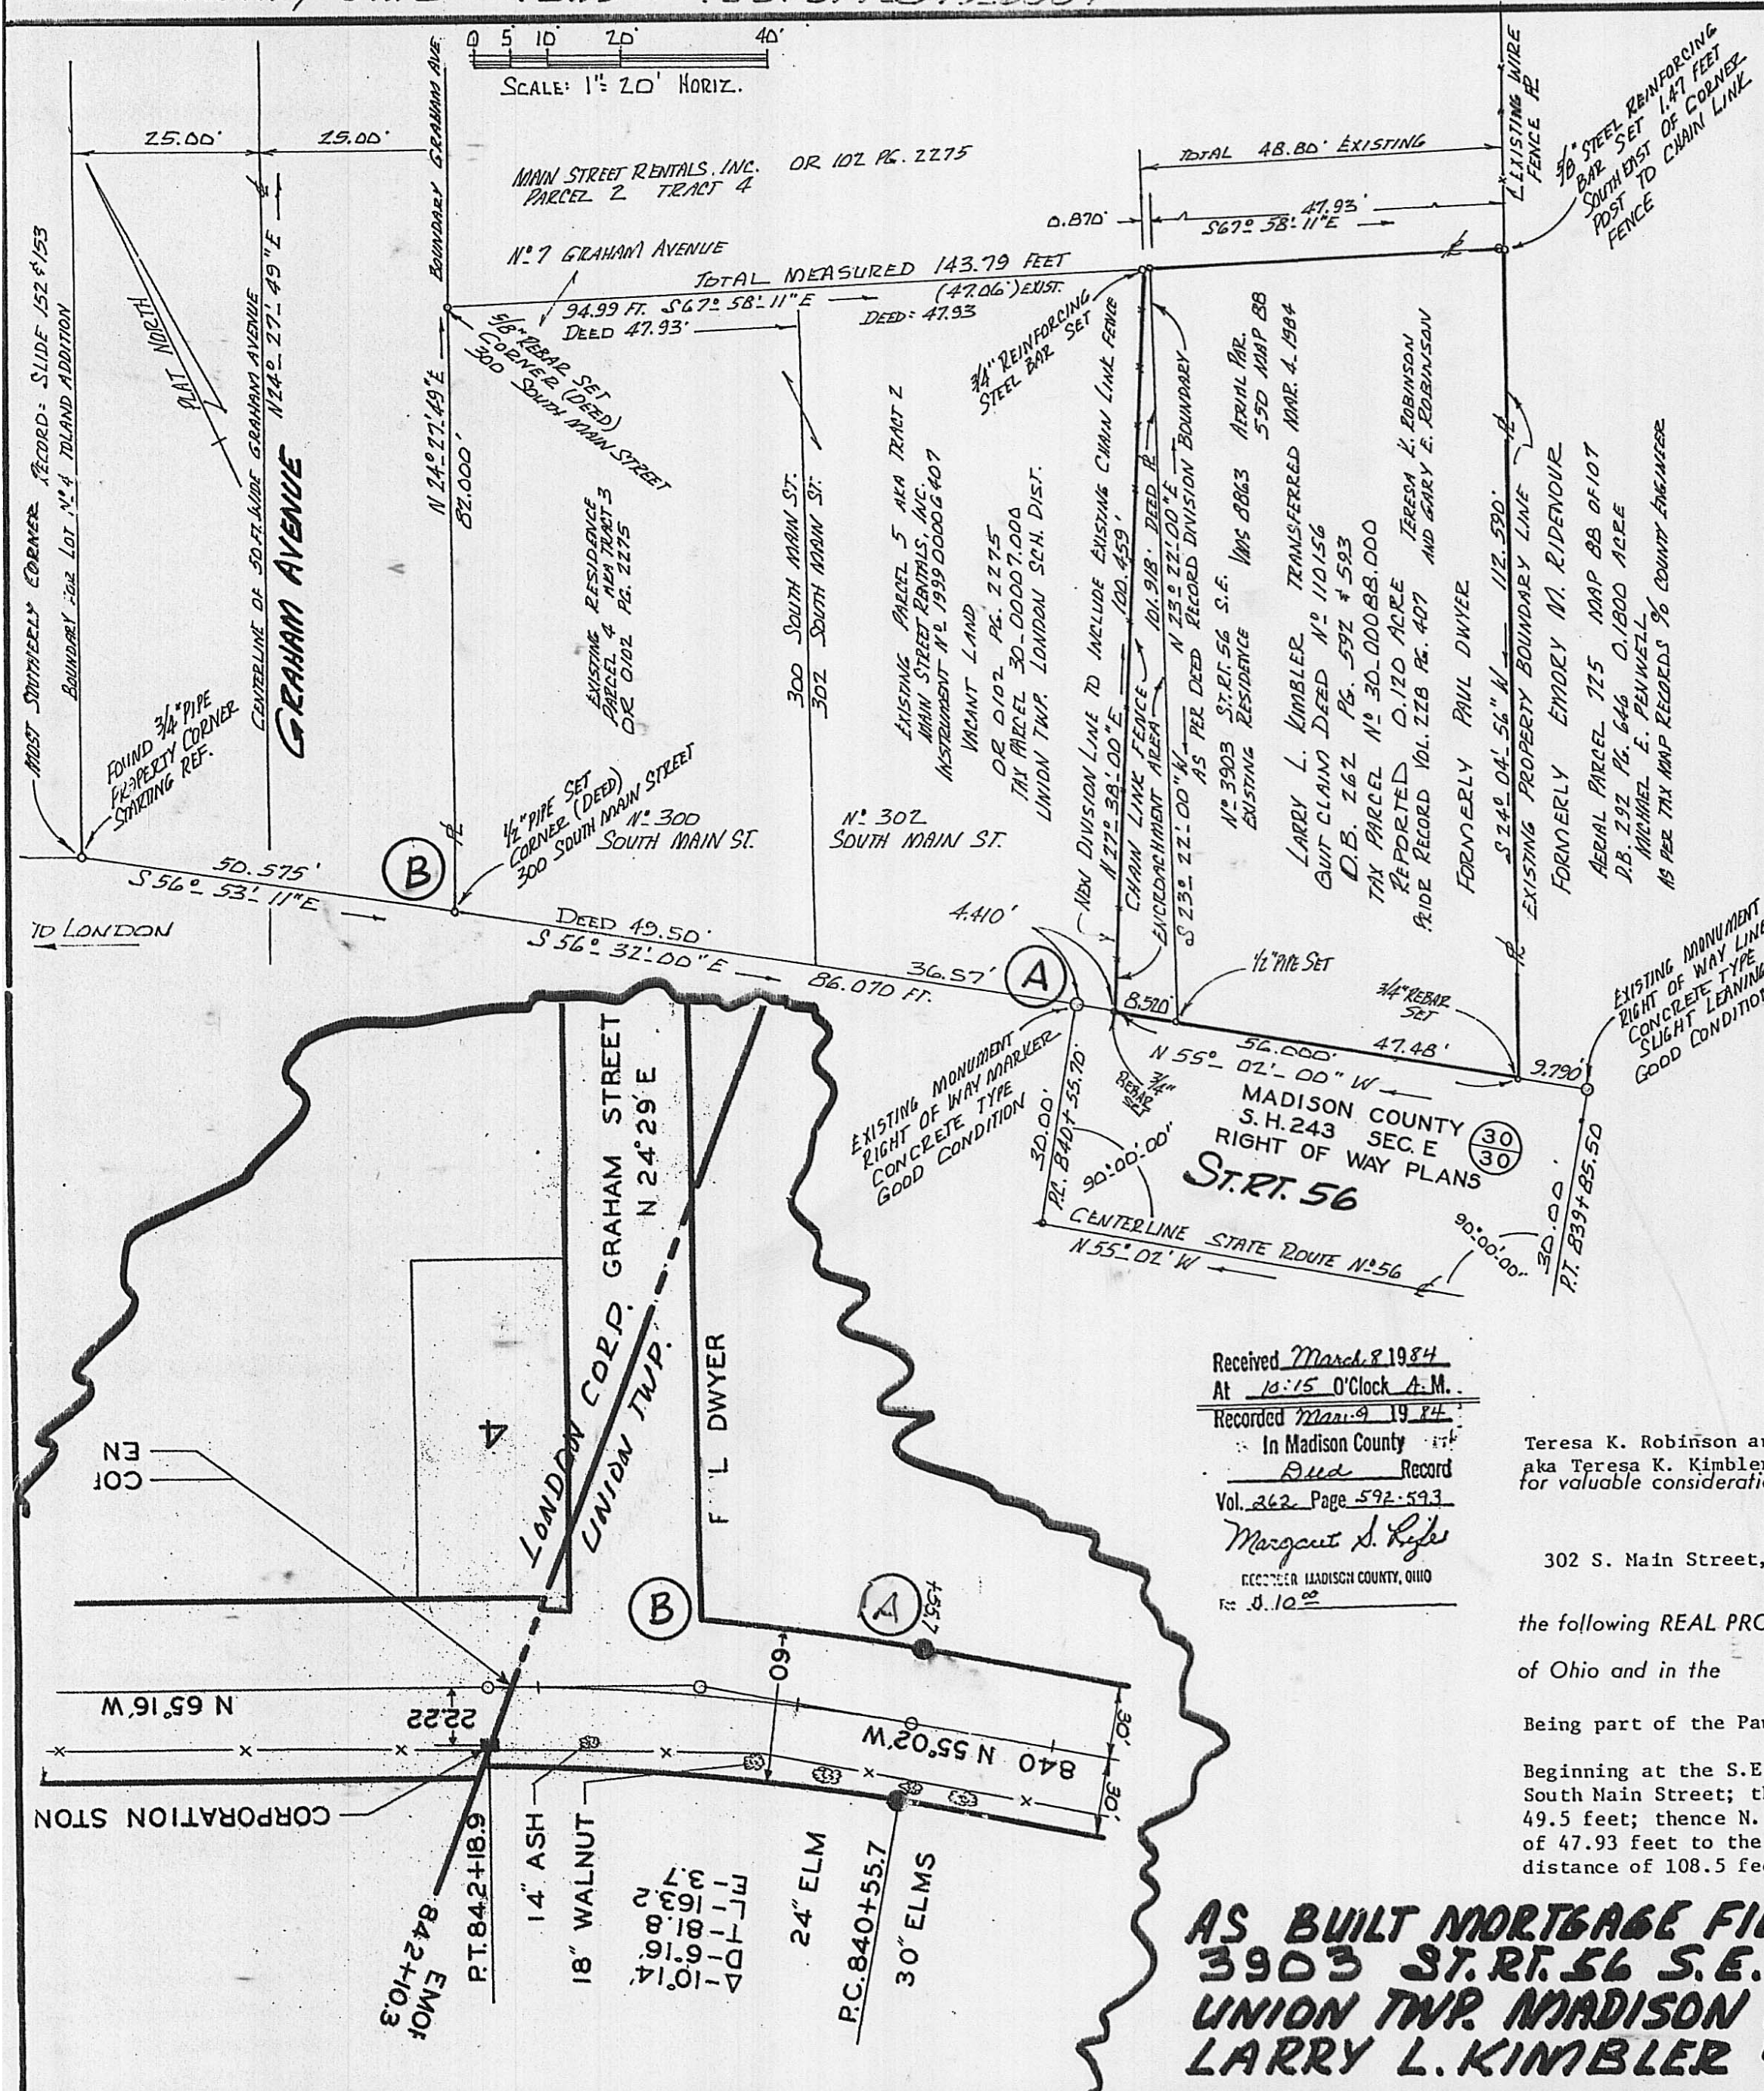


I CERTIFY THAT THIS "AS BUILT PLAT" IS BASED ON AN EXISTING FIELD SURVEY WITH ENCROACHMENT DEPICTED HEREON.
 PL = PROPERTY LINE R/W = RIGHT OF WAY
 CL = CENTERLINE X = FENCE

Rodger Irwin Baker P.S. FEB. 14. 1900
 RODGER IRWIN BAKER P.S. S.O.O. 5539
 1300 PLAIN CITY, GEORGESVILLE ROAD (SOUTH)
 GALLOWAY, OHIO 43119 TEL: 614-872-6004

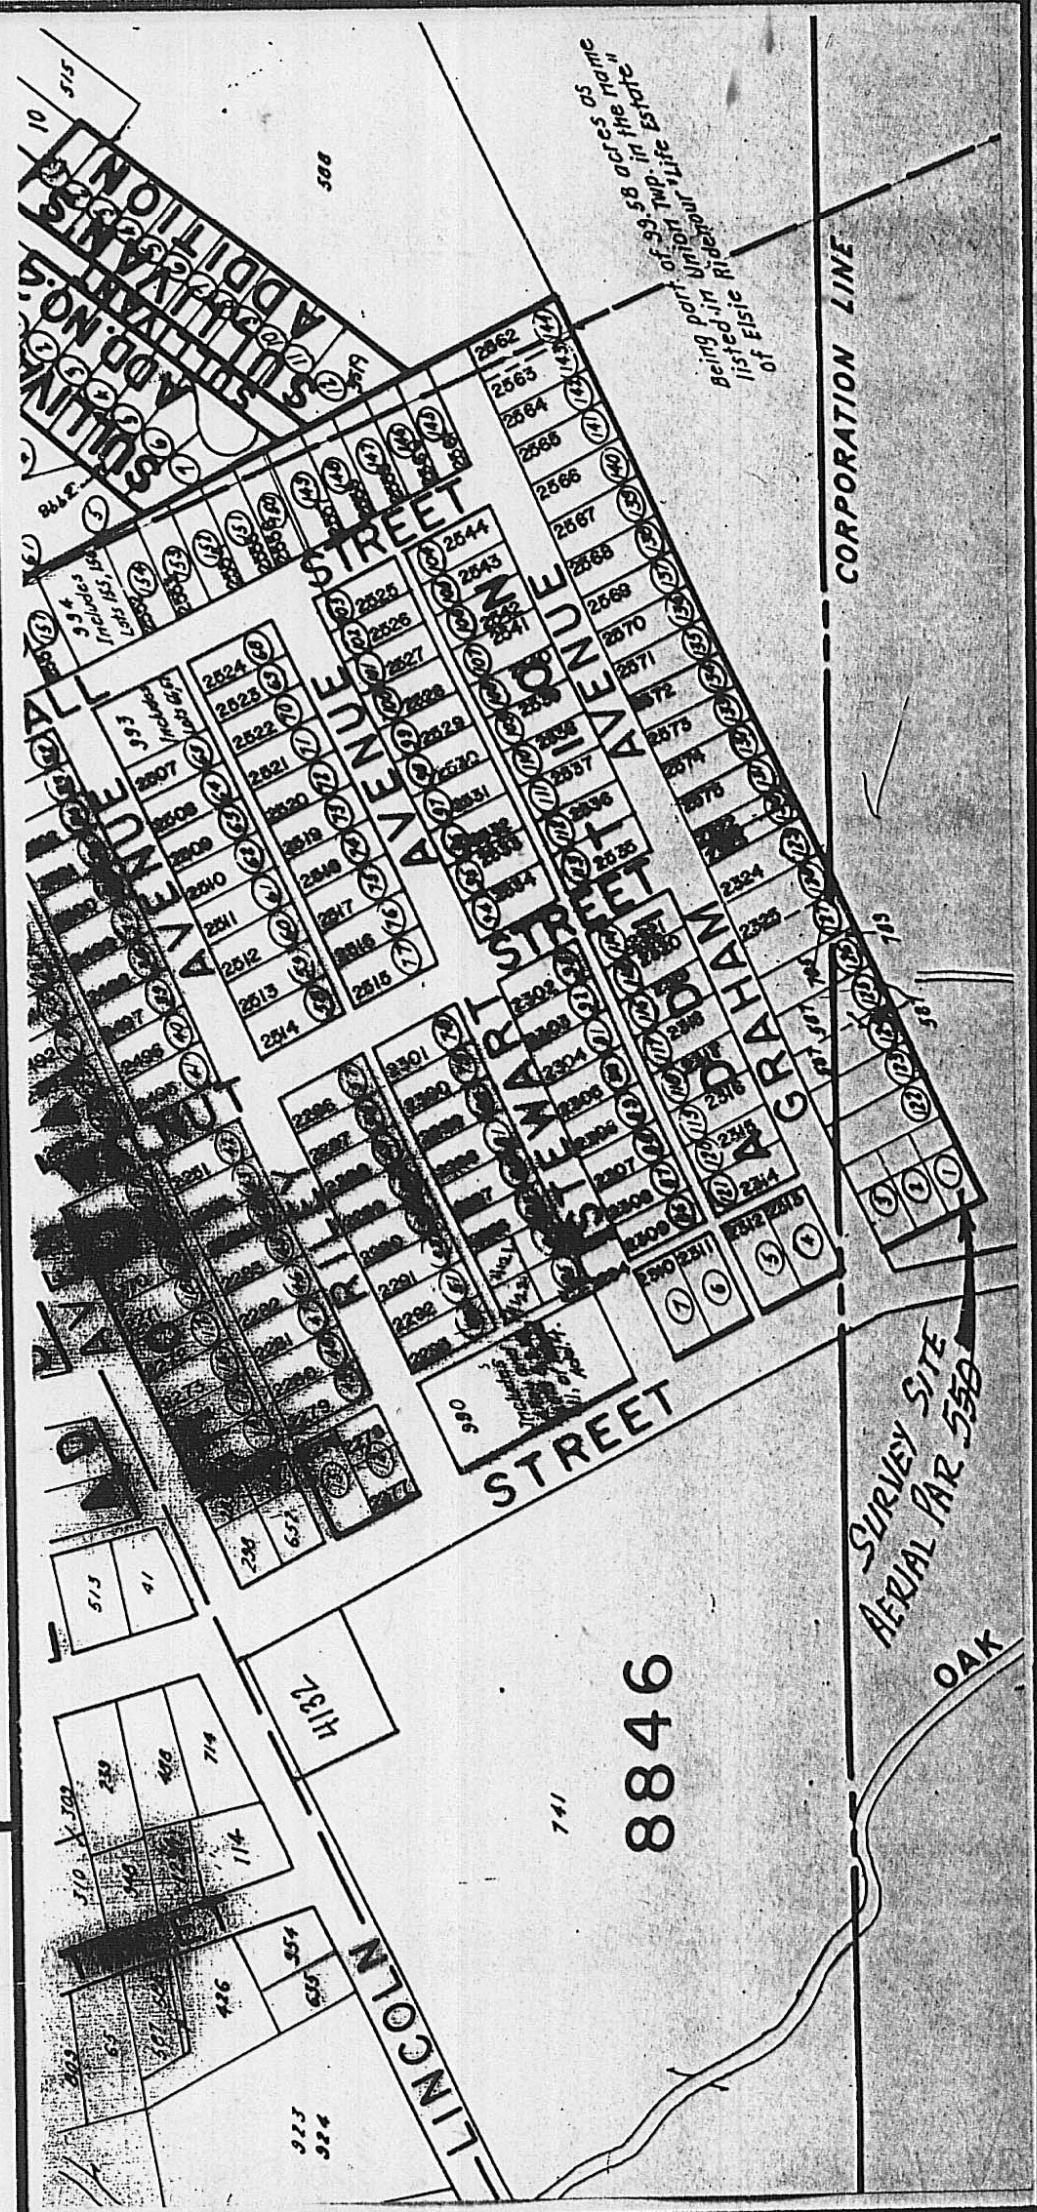

QUIT-CLAIM DEED *

Received March 8 1984
 At 10:15 O'Clock A.M.
 Recorded March 9 1984
 In Madison County
 and Record
 Vol. 262 Page 592-593
 Margaret A. Rife
 RECORDER MADISON COUNTY, OHIO
 Feb. 8. 1984

Teresa K. Robinson and Garry E. Robinson⁽¹⁾, of Madison County,
 aka Teresa K. Kimbler
 for valuable consideration paid, grants(s) to Larry L. Kimbler
 , whose tax-mailing address is
 302 S. Main Street, London, Ohio 43140

the following REAL PROPERTY: Situated in the County of Madison in the State
 of Ohio and in the Township of Union :

Being part of the Paul Dwyer .66 acre tract in V.M.S. 11325 and described as follows:
 Beginning at the S.E. corner of the said .66 acre tract and in the easterly line of
 South Main Street; thence along said South Main Street N. 50° 22' W. a distance of
 49.5 feet; thence N. 27° 56' E. a distance of 99.0 feet; thence S. 61° 21' E. a distance
 of 47.93 feet to the easterly line of said .66 acre tract; thence S. 27° 29' W. a
 distance of 108.5 feet to the place of beginning, containing 0.12 acres, more or less.

AS BUILT MORTGAGE FIELD SURVEY REPORT
3903 ST. RT. 56 S.E. LONDON, OHIO 43140
UNION TWP. MADISON CO. OHIO
LARRY L. KIMBLER & OTHERS

53-06