


FINAL SURVEY
 SURVEYED _____
 PLOTTED _____
 NOTE BOOK NO. _____
 DATE _____
 AREAS CHECKED _____

ORIGINAL SURVEY
 SURVEYED _____
 PLOTTED _____
 NOTE BOOK NO. _____
 DATE _____
 AREAS CHECKED _____

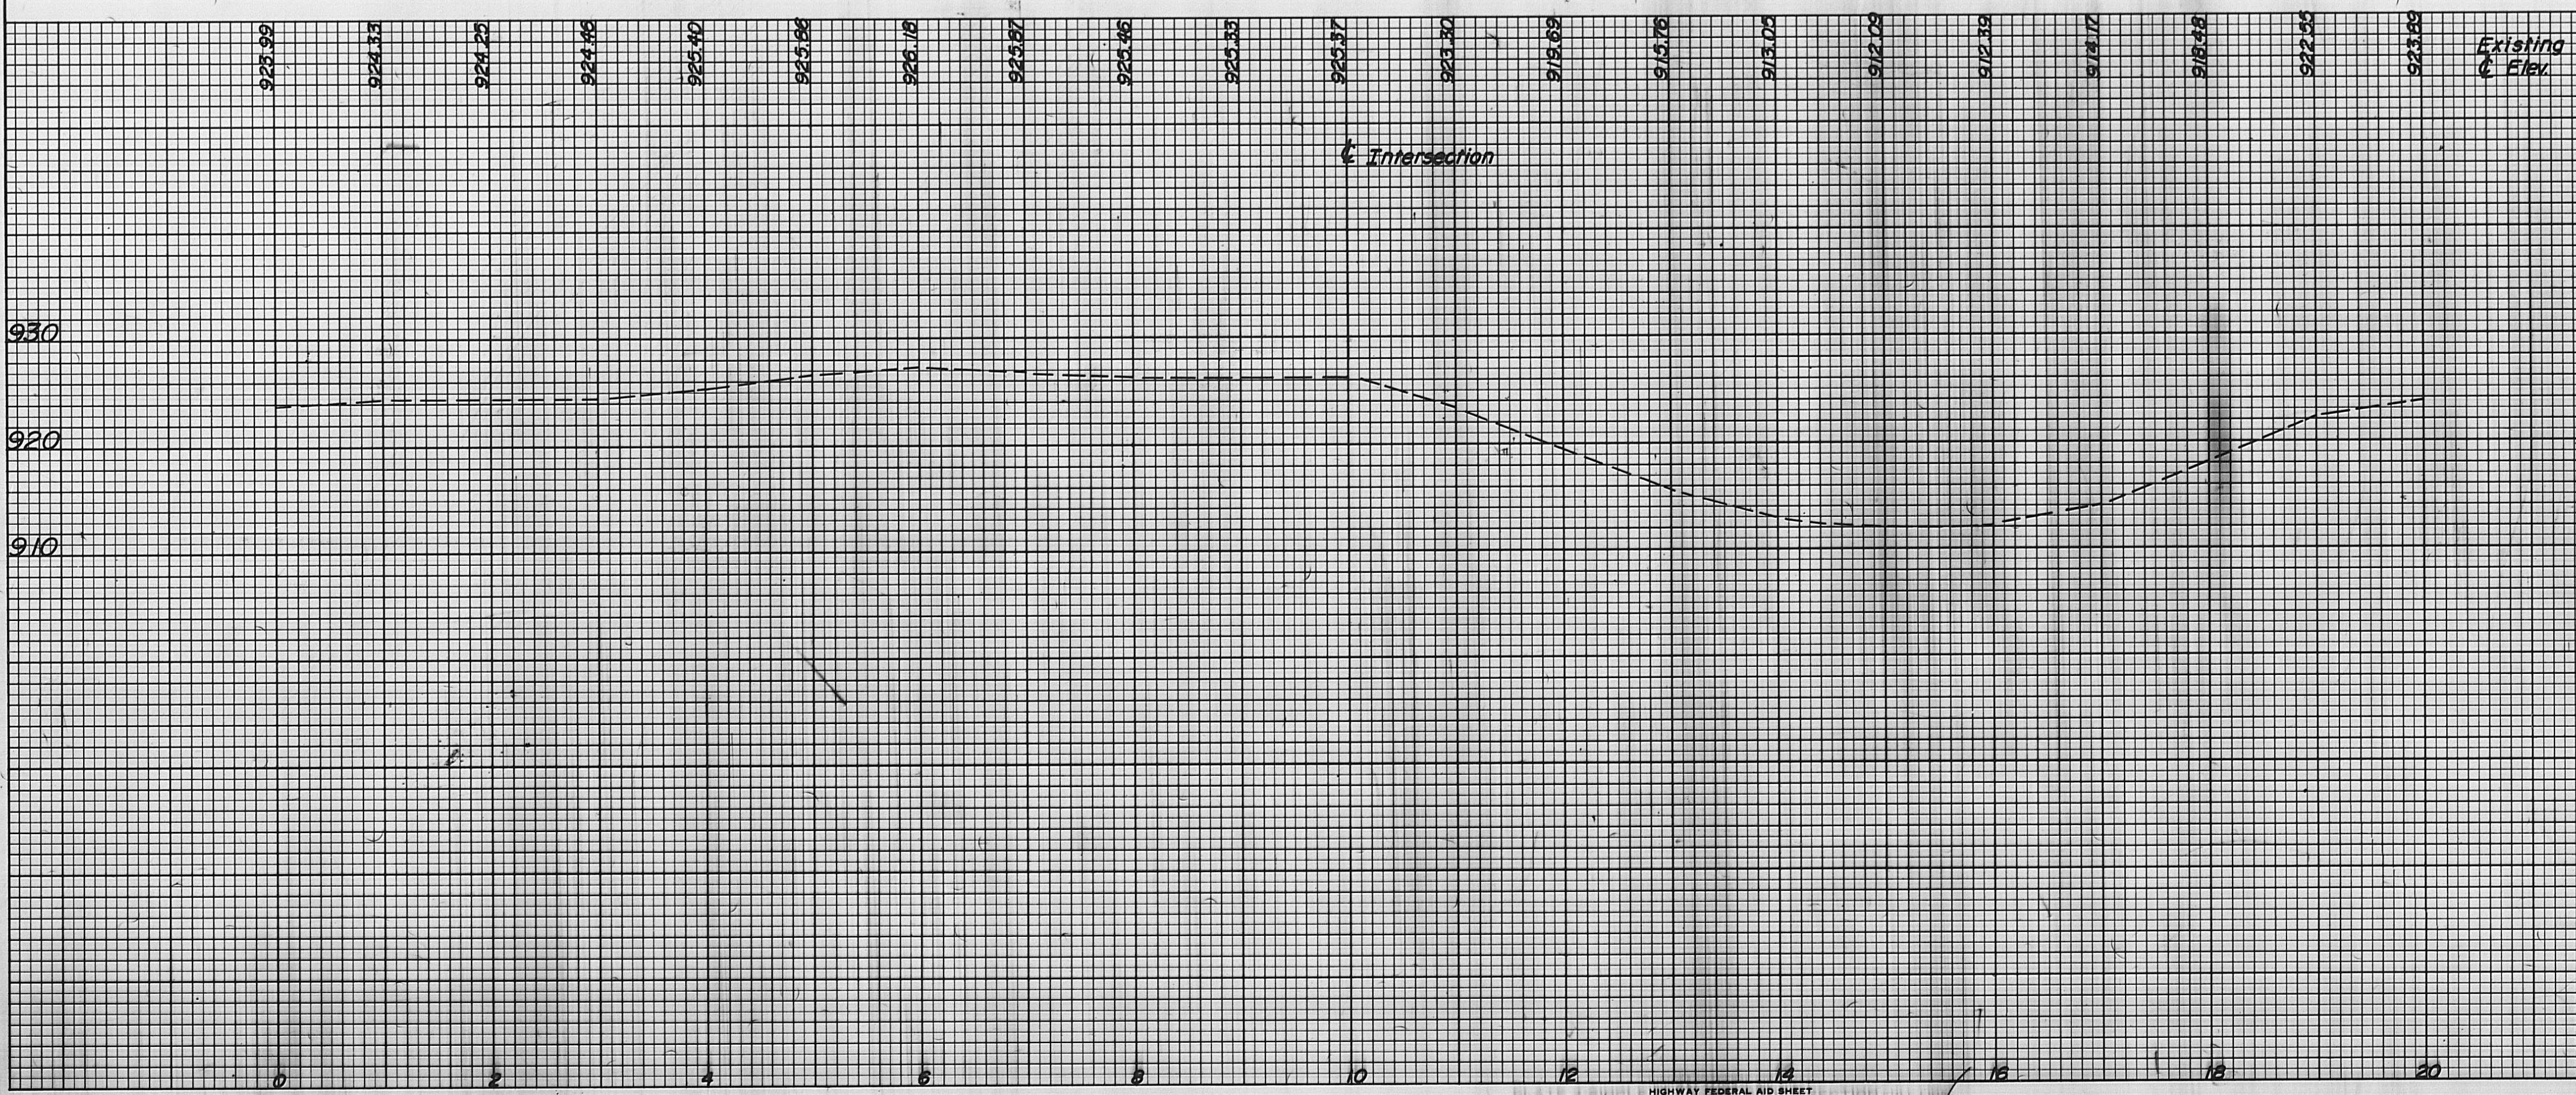

AS BUILT PLAN
DARBY GLEN
 Canaan Twp., Madison County, Ohio
 Plain City - Georgesville Road
 Plan And Profile
HUGHES ENGINEERING
 COLUMBUS, OHIO