


FINAL SURVEY PLOTTED AREAS CHECKED

BY: _____ DATE: _____


NO. _____

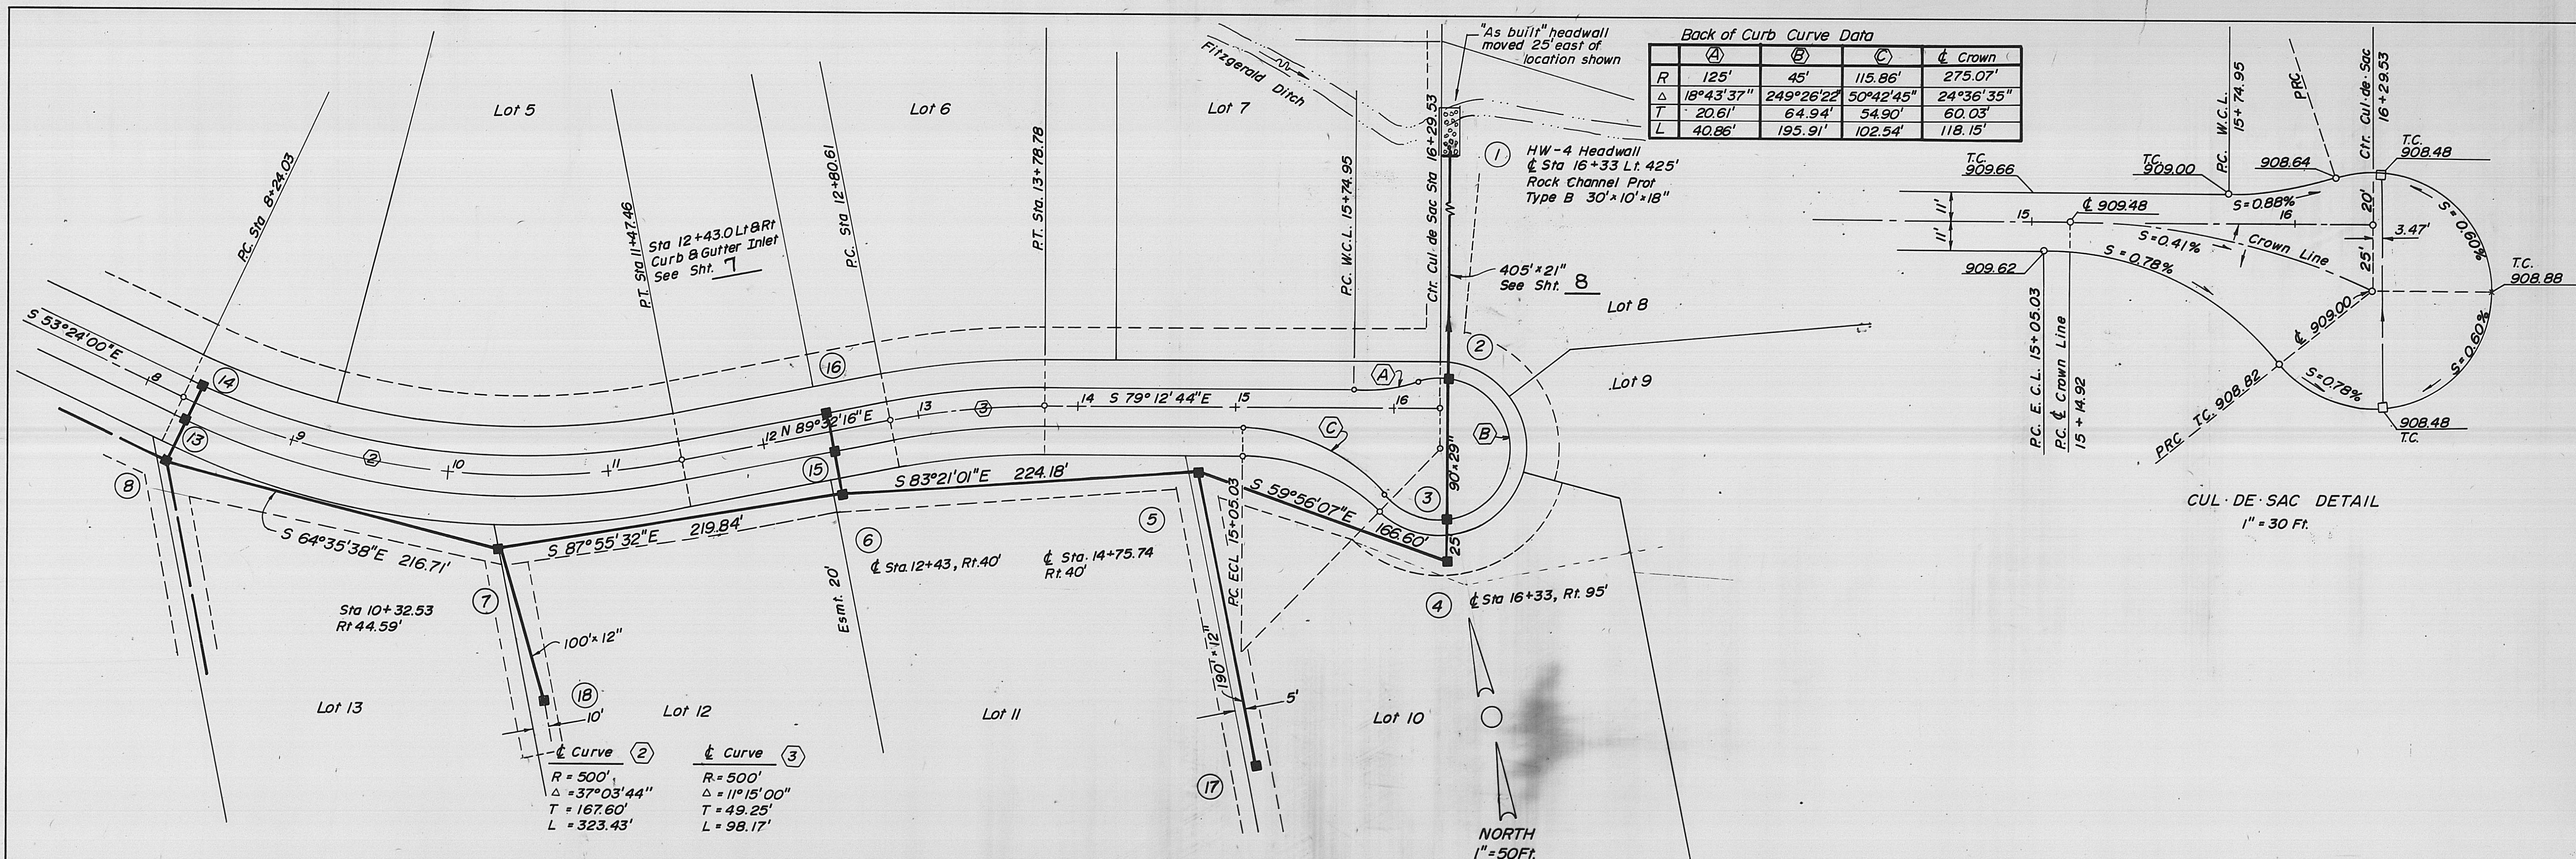

ORIGINAL SURVEY PLOTTED AREAS CHECKED

BY: _____ DATE: _____

NO. _____

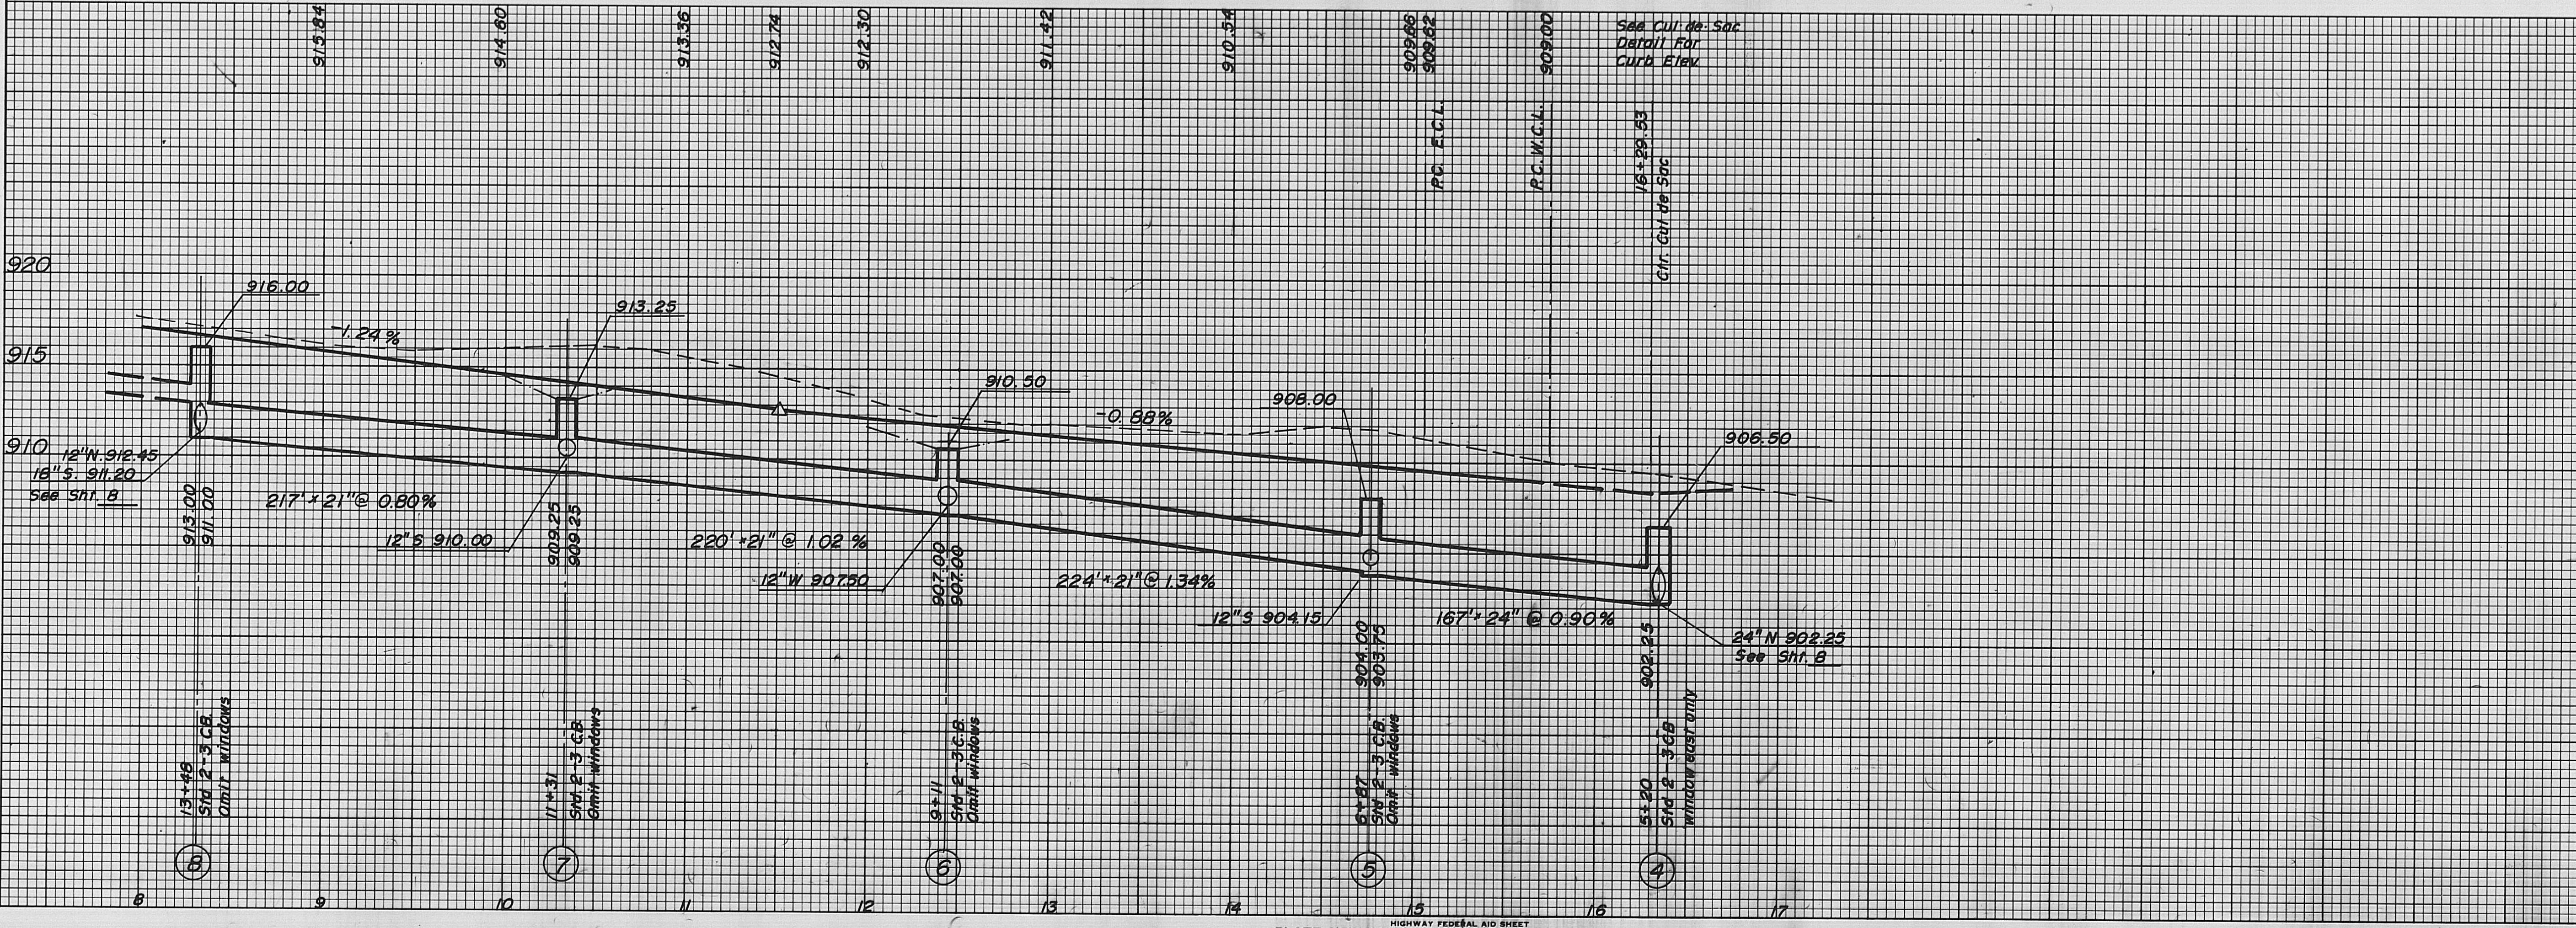

AS BUILT PLAN

DARBY GLEN

Canaan Twp., Madison County, Ohio

Glen View Drive Plan & Profile

HUGHES ENGINEERING
COLUMBUS, OHIO