
AUTUMN HAZE SUBDIVISION

SECTION TWO

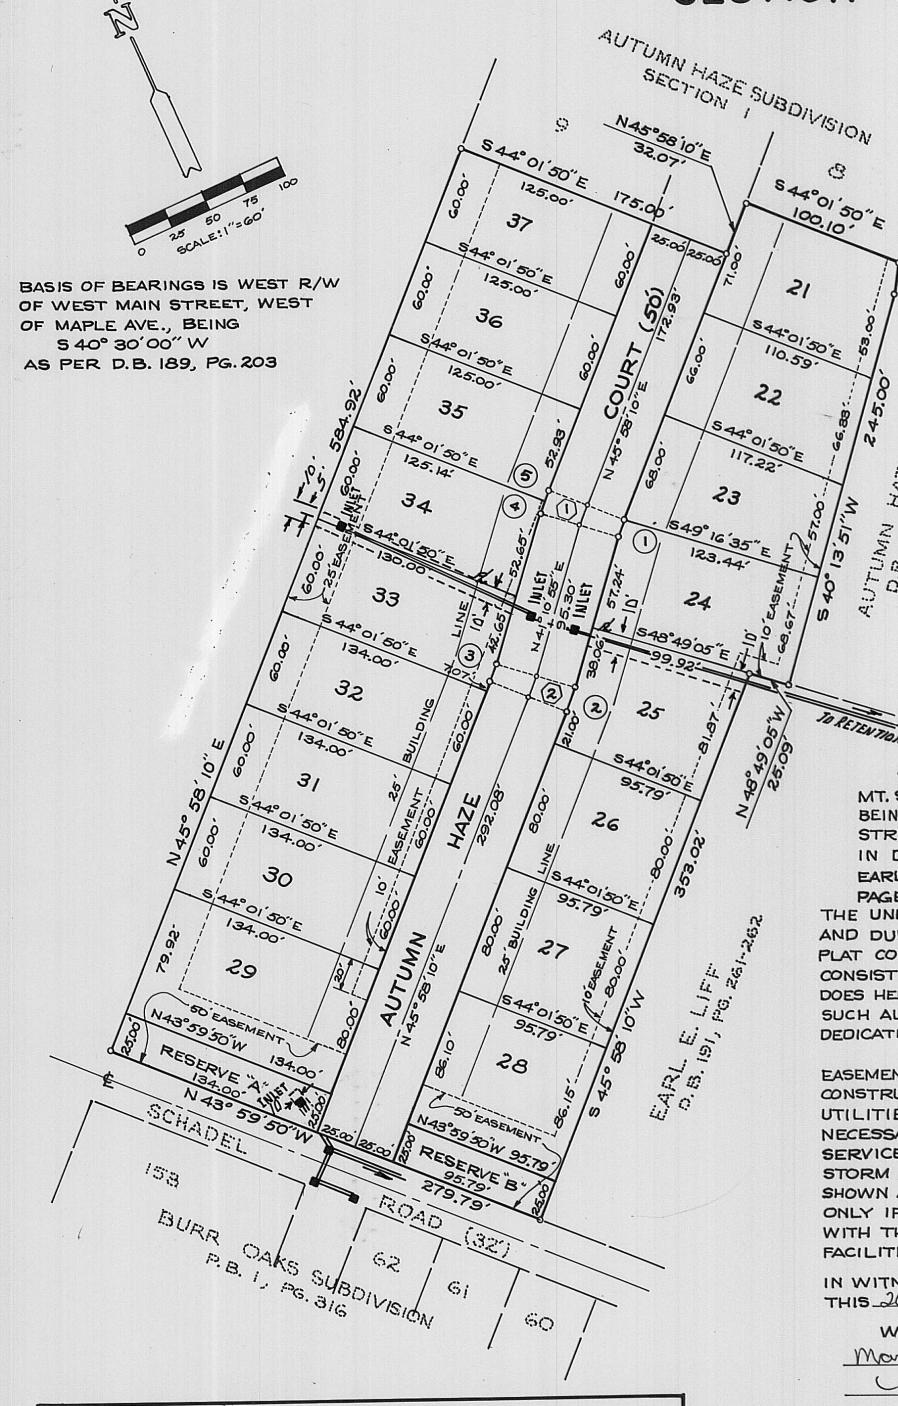

E ROAD CURVE DATA								
NO.	Δ	R	Т	L	CH	CH. BEARING		
(1)	4° 47′ 15″	150'	6.27	12.53	12.53	N43°34'32" E		
<u>a</u>	4° 47′ 15″	150	6.27	12.53	12.53	N43° 34′ 82″ E		
LOT DIMENSIONS								
NO.	Δ	R	T	L	СН	CH. BEARING		
	4° 47′ 15″	12 <i>5</i> ′	5.23	10.44	10.44	N43° 34′ 32″ E		
(2)	4° 47′ 15″	175'	7.32	14.62	14.62	N 43° 34′ 32″ E		
(3)	4° 47′ 15″	125	5.23	10.44	10.44	N43° 34′ 32″ E		
(<u>4</u>)	2° 28′ 24″	175	3.78	7.55	7.55	N42° 25' 07" E		
5	2° 18′ 51″	175	3. <i>53</i> ′	7.07	7.07	N 44° 48′ 45″ E		

TO BE PLACED UPON COMPLETION OF CONSTRUCTION ARE INDICATED BY THE SYMBOL .

	DELAWARE, OHIO 43015	
5 171	Charles R. Welle	

REGISTERED SURVEYOR NO. 6186

SITUATED IN THE STATE OF OHIO, COUNTY OF MADISON, VILLAGE OF MT. STERLING, BEING IN V.M.S. 12140, AND CONTAINING 3.906 ACRES, BEING PART OF THAT TRACT CONVEYED TO EARL E. LIFF, 5 S. MARKET STREET, MT. STERLING, OHIO, BY DEED OF RECORD AS DESCRIBED IN DEED BOOK 191, PAGE 261-262, AND PART OF THAT TRACT CONVEYED TO EARL E. LIFF BY DEED OF RECORD AS DESCRIBED IN DEED BOOK 276,

PAGE 841 AND 842.
THE UNDERSIGNED, EARL E. LIFF, OWNER OF THE LAND HEREIN DESCRIBED, AND DULY AUTHORIZED IN THE PREMISES, DOES HEREBY CERTIFY THAT THIS PLAT CORRECTLY REPRESENTS HIS AUTUMN HAZE SUBDIVISION, SECTION TWO, CONSISTING OF LOTS 21 THROUGH 37, AND RESERVES A AND B, INCLUSIVE, AND DOES HEREBY ACCEPT THIS PLAT OF SAME AND DEDICATE TO PUBLIC USE AS SUCH ALL OR PARTS OF THE COURT SHOWN HEREON AND NOT HERETOFORE DEDICATED.

EASEMENTS ARE RESERVED WHERE INDICATED ON THE PLAT FOR THE CONSTRUCTION, OPERATION AND MAINTENANCE OF ALL PUBLIC AND PRIVATE UTILITIES, ABOVE AND BENEATH THE SURFACE OF THE GROUND, AND WHERE NECESSARY, FOR THE CONSTRUCTION, OPERATION, AND MAINTENANCE OF SERVICE CONNECTIONS TO ALL ADJACENT LOTS AND LANDS, AND FOR STORM WATER DRAINAGE, SURFACE AND UNDERGROUND. THE EASEMENTS SHOWN ARE RESERVED FOR UNDERGROUND CABLE TELEVISION FACILITIES, ONLY IF SUCH UNDERGROUND FACILITIES ARE INSTALLED CONCURRENTLY WITH THE INSTALLATION OF ELECTRIC AND TELEPHONE COMPANIES FACILITIES.

IN WITNESS WHEREOF EARL E. LIFF HAS HEREUNTO SET HIS HAND THIS JUTA DAY OF MAY, 1989.

Mordina Bennett Melly C. LiBer

OWNER SALL E. LIFF

STATE OF OHIO, S.S. COUNTY OF MADISON

BEFORE ME, A NOTARY PUBLIC IN AND FOR SAID COUNTY, PERSONALLY CAME EARL E. LIFF, WHO ACKNOWLEGES THE SIGNING OF THE FOREGOING INSTRUMENT TO BE HIS FREE AND VOLUNTARY ACT AND DEED FOR THE USES AND PURPOSES THEREIN EXPRESSED. IN WITNESS WHEREOF I HAVE HEREUNTO SET MY HAND AND AFFIXED MY OFFICIAL SEAL THIS 26 HOAY OF MAY, 1989.

MARY C. LeBEAU

NOTARY PUBLIC, STATE OF OHIO

MY COMMISSION EXPIRES SEPT. 8, 1993

NEW STORM INLET & GRATE

NEW STORM SUBSURFACE LINE
IN 10' WIDE DRAINAGE EASEMENT
AS BUILT CONSTRUCTION

SEPT. 4 TH. 1991

RODGER J. BAKER

WOLFE ENGINEERING

APPROVED BASS Maginia B. Lehmen Club
MADISON COUNTY AUDITOR Paymond M. Weimer
TRANSFERRED THIS 18 DAY OF Sept., 1980.

MADISON COUNTY RECORDER Margaret S. Ref.
RECORDED THIS 18 DAY OF September, 1980.

PLAT BOOK PAGE NO. Slide 614

By: Some Siekens - Light Jime: 12:35 P.m.

Approved 626-39 Toright W Control Chairm

DATE PARKING COMMISION

RESOLUTION No. 1989-7