


DATE _____
 BY _____
 SURVEYED _____
 PLOTTED _____
 FINAL SURVEY _____
 NOTE BOOK _____
 NO. _____
 AREAS CHECKED _____

DATE _____
 BY _____
 SURVEYED _____
 PLOTTED _____
 ORIGINAL SURVEY _____
 NOTE BOOK _____
 NO. _____
 AREAS CHECKED _____

STA	END AREA		VOLUME	
	CUT	FILL	CUT	FILL
9+50	8	12	22	23
9+00	6	13	9	27
8+50	4	16	7	27
8+00	4	3	11	21
7+50	8	10	15	16
7+00	8	7	11	15
6+50	4	9	11	17
6+00	8	10	13	18
5+50	6	9	11	18
5+00	6	10	12	20
4+50	7	12	13	22
4+00	7	12	18	11
3+50	12	0	15	8
3+00	4	0	4	8
2+60	0	0		
Total			172	251

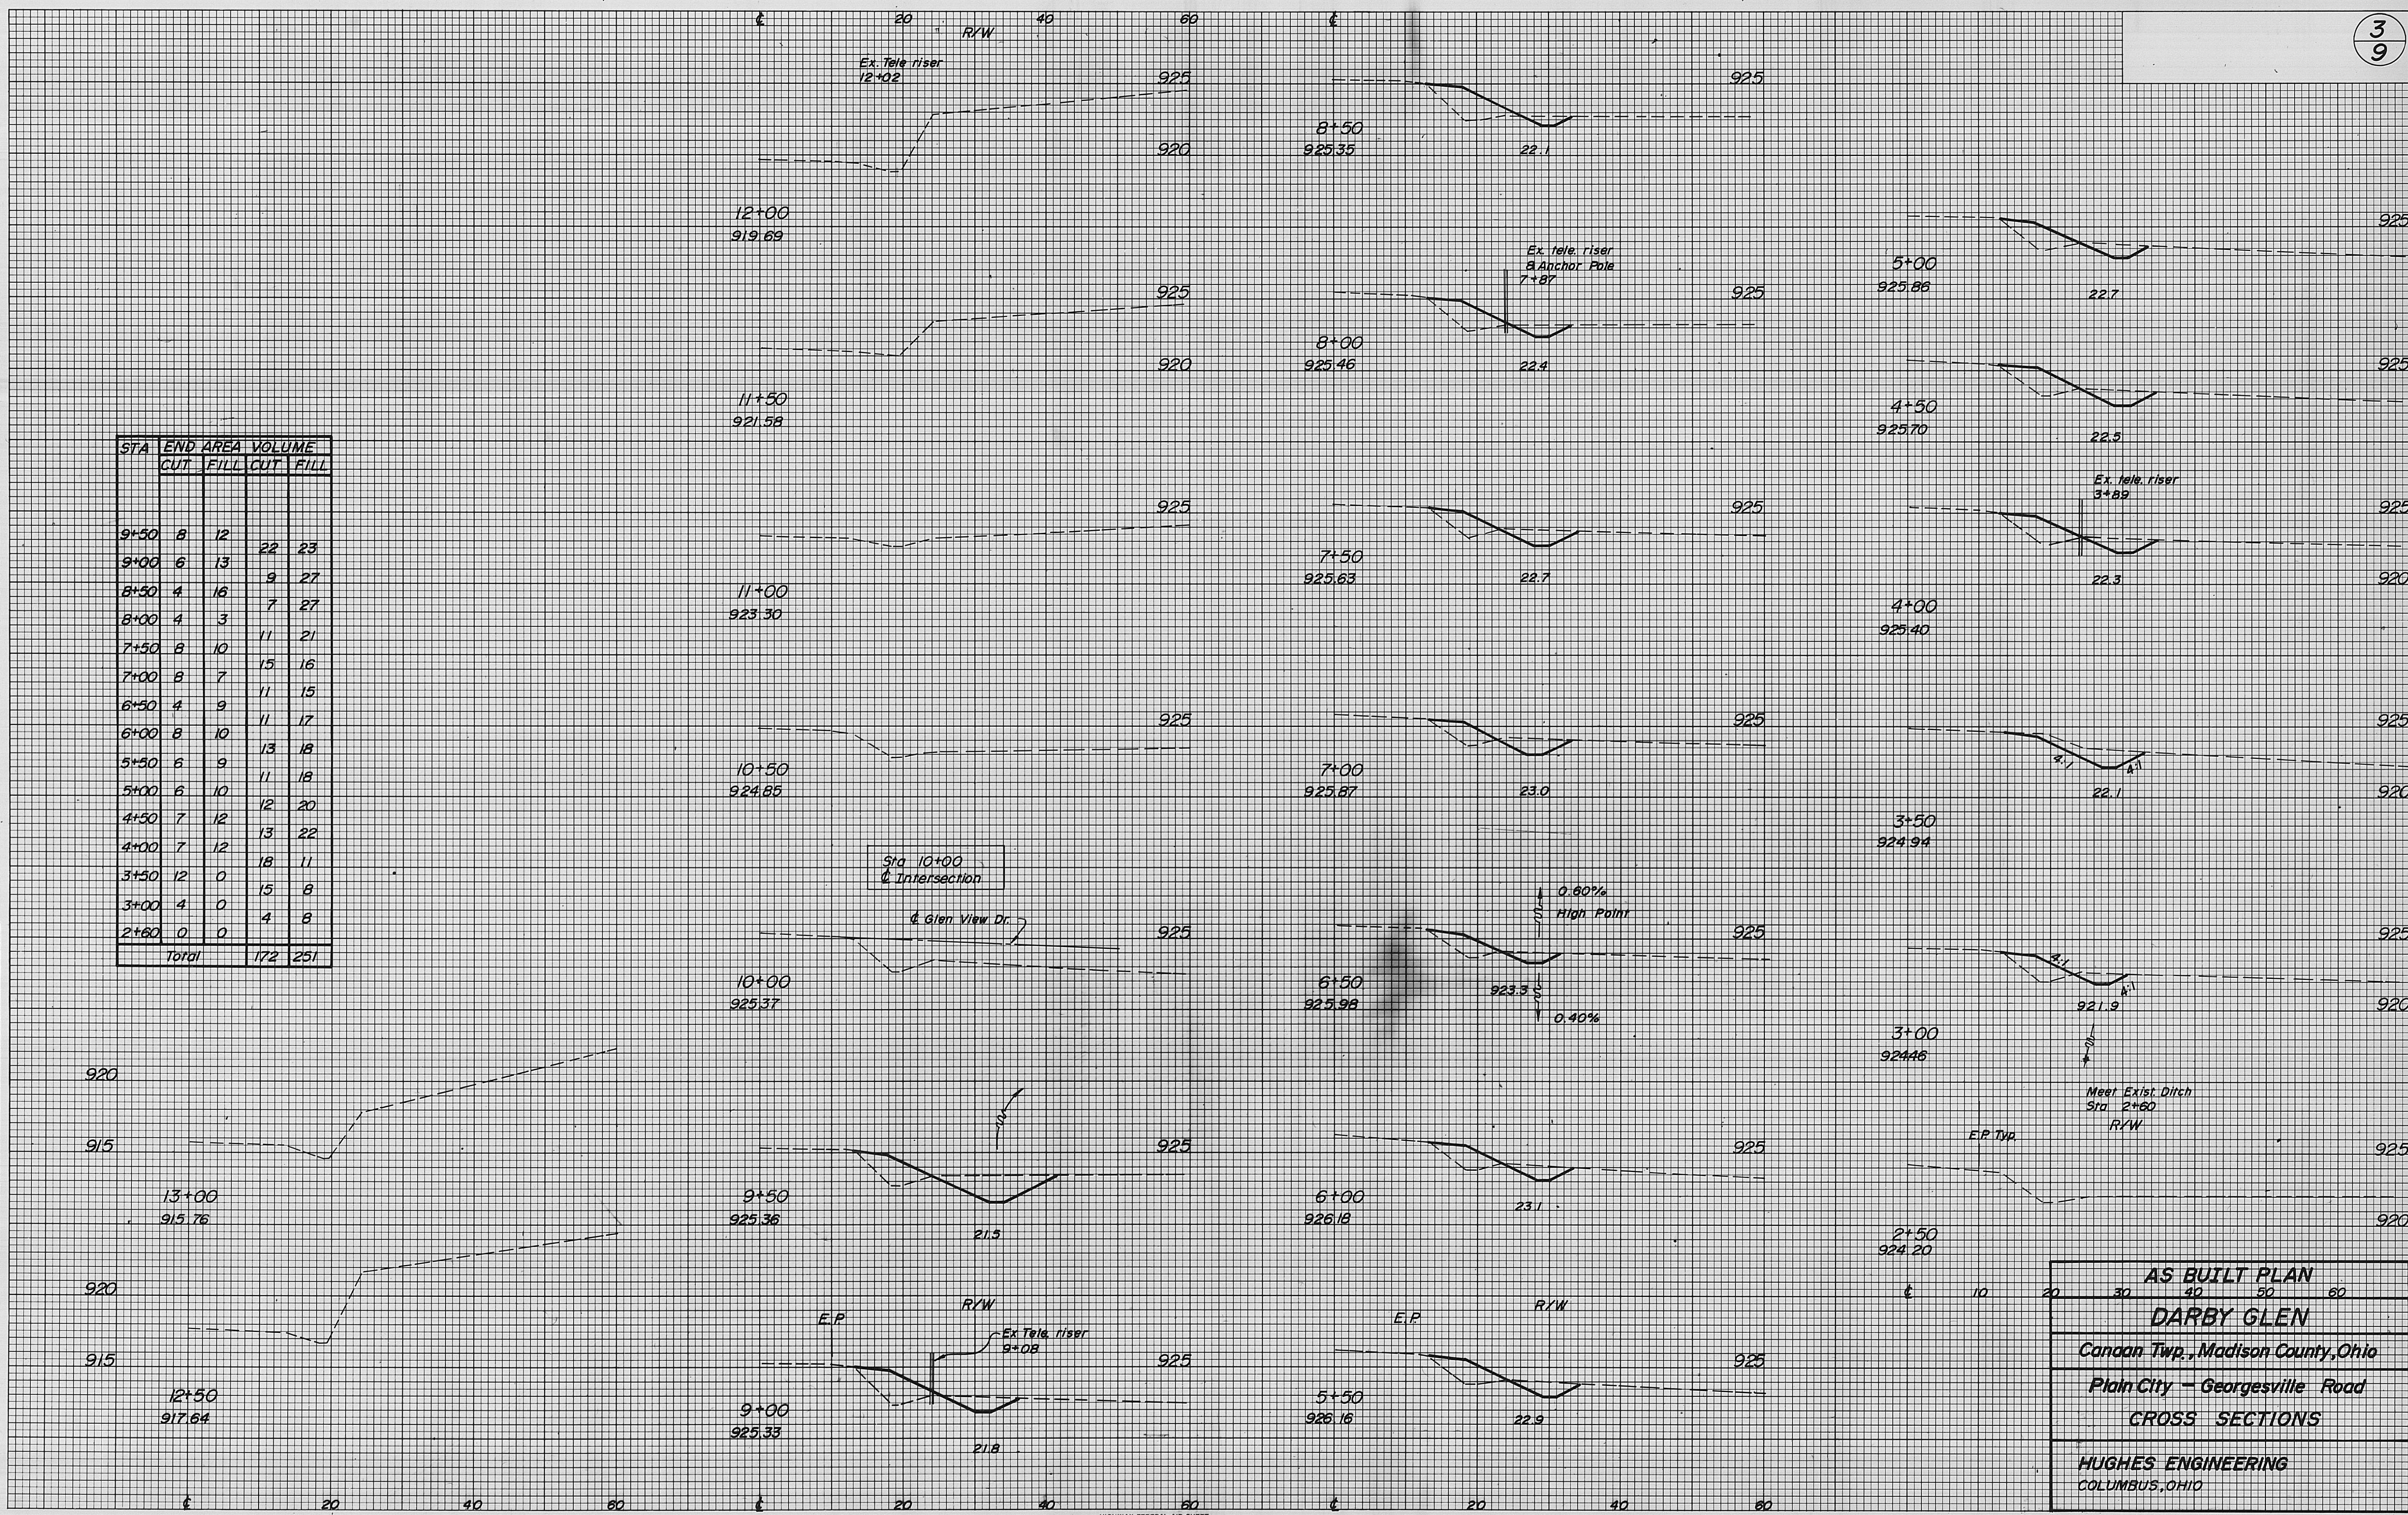

AS BUILT PLAN
DARBY GLEN
 Canaan Twp., Madison County, Ohio
 Plain City - Georgesville Road
CROSS SECTIONS
 HUGHES ENGINEERING
 COLUMBUS, OHIO